
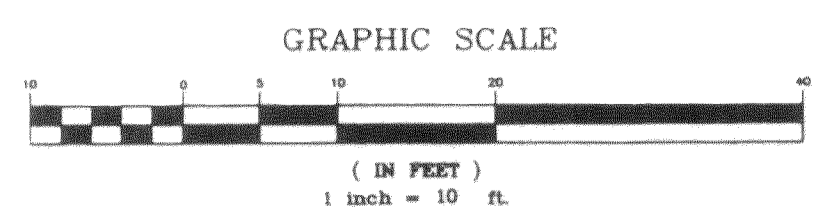
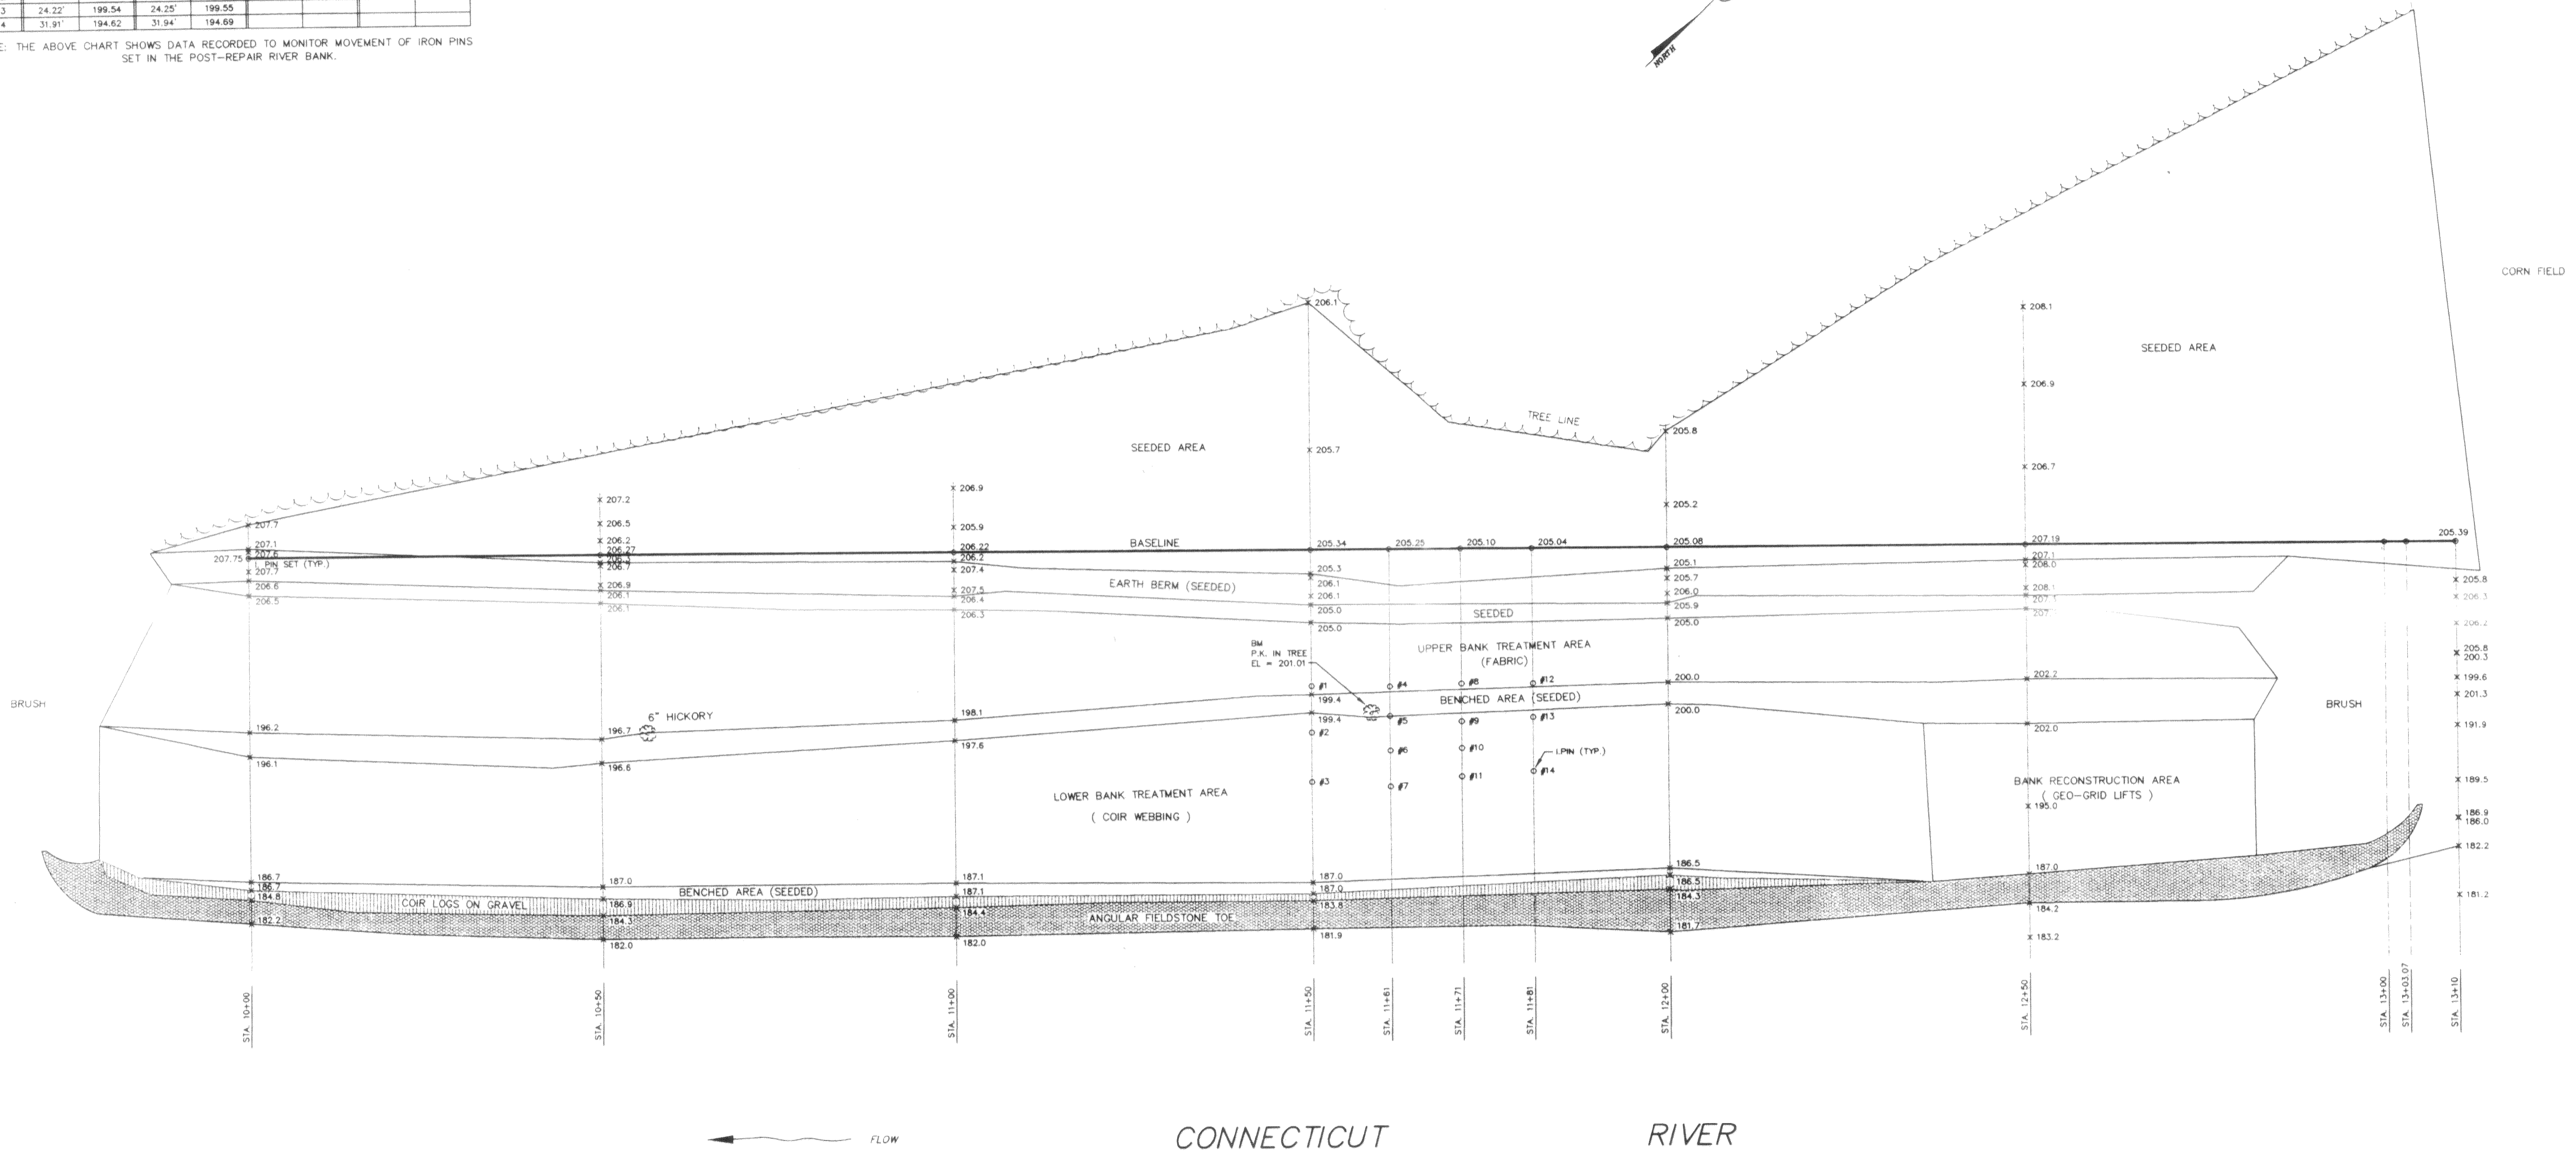


I. PIN	MAY 7, 1998 NB. 236/71-72		JUNE 18, 1998 NB. 211/67	
	OFFSET FROM B/L	ELEVATION	OFFSET FROM B/L	ELEVATION
1	19.56'	200.45	19.50'	200.45
2	26.21'	198.26	26.18'	198.26
3	33.26'	193.75	33.25'	193.78
4	19.79'	200.80	19.81'	200.83
5	23.94'	200.29	23.94'	200.31
6	28.88'	196.97	28.88'	196.97
7	33.98'	193.45	33.98'	193.44
8	19.37'	200.81	19.39'	200.84
9	24.78'	198.81	24.78'	198.70
10	28.60'	196.62	28.65'	196.60
11	32.61'	194.33	32.65'	194.37
12	19.38'	200.43	19.41'	200.43
13	24.22'	199.54	24.25'	199.55
14	31.91'	194.62	31.94'	194.69

NOTE: THE ABOVE CHART SHOWS DATA RECORDED TO MONITOR MOVEMENT OF IRON PINS SET IN THE POST-REPAIR RIVER BANK.

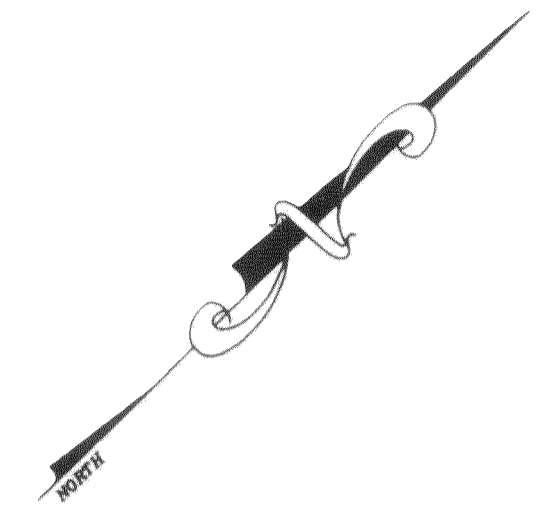

ELEVATIONS SHOWN ARE BASED UPON NGVD
 FIELD BOOK 237 / 9 - 11 (DATE OF SURVEY ???)
 236 / 71 - 72
 211 / 67

SHEET 1 OF 3		NORTHEAST UTILITIES SERVICE CO. FOR WESTERN MASSACHUSETTS ELECTRIC COMPANY W. SPRINGFIELD, MASS.	
TITLE WICKEY SITE AS-BUILT CONNECTICUT RIVER BANK STABILIZATION GILL, MASS.		BY JM DATE DEC. 11, 1996 SCALE 1" = 10'	
DATE 9/26/98		DATE	
REVISIONS		DATE	
BY		DATE	
CHK		DATE	
APP		DATE	
APP		DATE	
P.A. #		DWG. NO. 75829-1	
PROJ. NO. 0-50.80		V.S. W-8-2	