
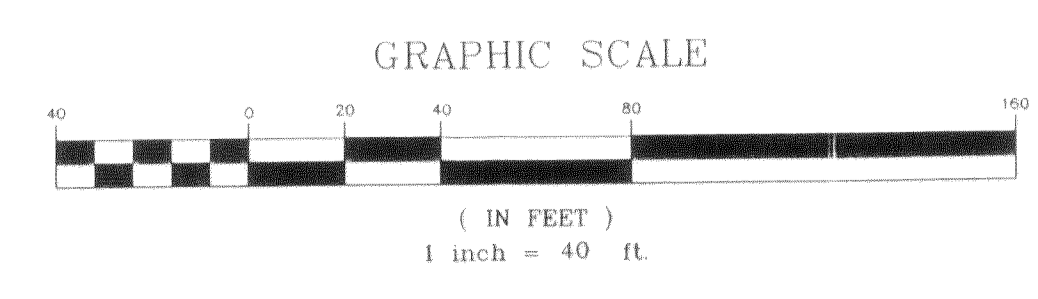


← FLOW


CONNECTICUT RIVER

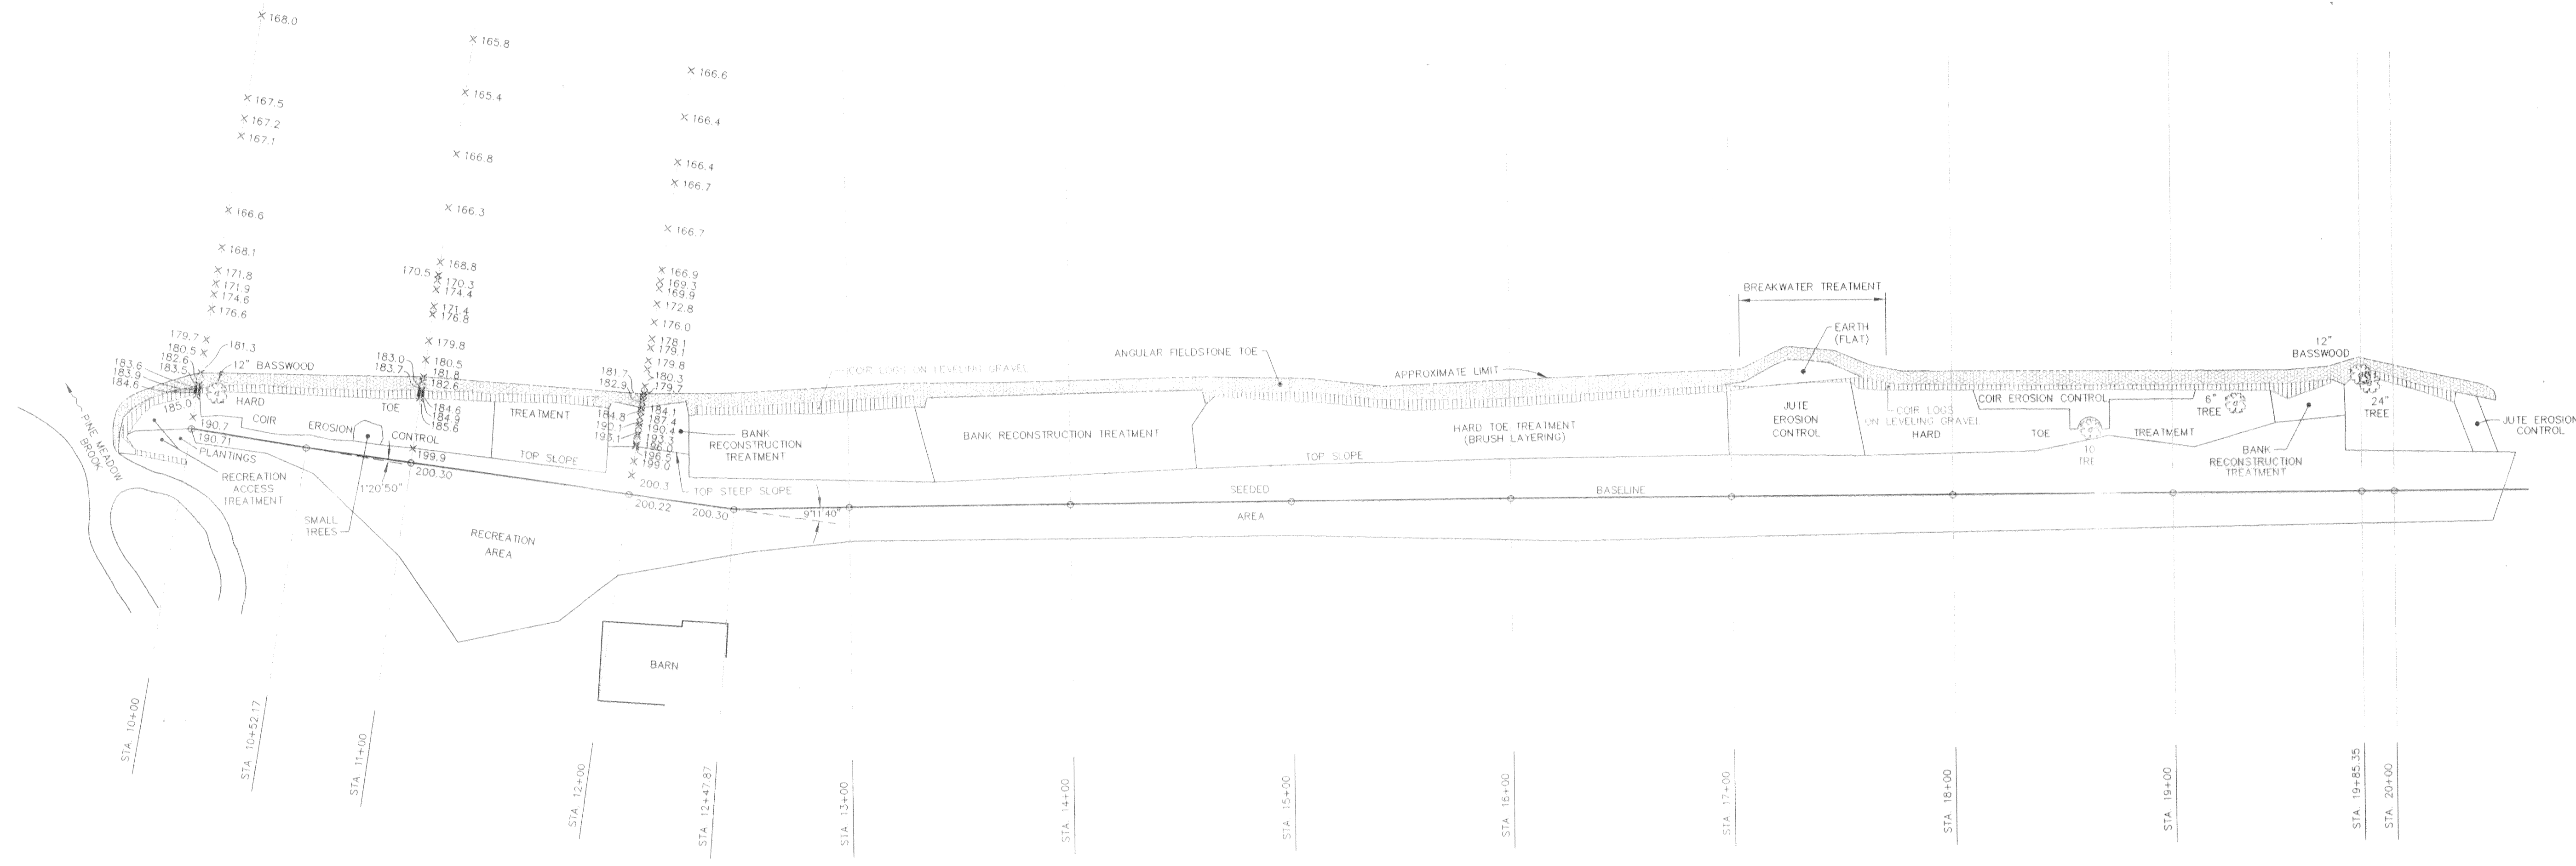

○ INDICATES I. PIN  
ELEVATIONS SHOWN ARE BASED UPON NGVD

FIELD BOOK 232 / 42 - 50  
DATE OF SURVEY 1/9/1997

REFERENCE DWG. 75825

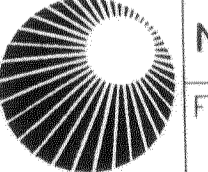REVISIONS DURING CONSTRUCTION		P.A. NO.	
 <b>NORTHEAST UTILITIES SERVICE CO.</b> FOR WESTERN MASSACHUSETTS ELECTRIC COMPANY W. SPRINGFIELD, MASS.			
TITLE SHEARER SITE AS-BUILT CONNECTICUT RIVER BANK STABILIZATION NORTHFIELD, MASS.			
BY J.M.	CHKD	APP	APP
DATE FEB. 11, 1997	DATE	DATE	DATE
SCALE 1" = 40'	MICROFILM DATE	DWG. NO.	75825-1
P.A. #		PROJ. NO. 0-50.80	V.S. W-8-2

NO.	DATE	REVISIONS	BY	CHK	APP	APP