

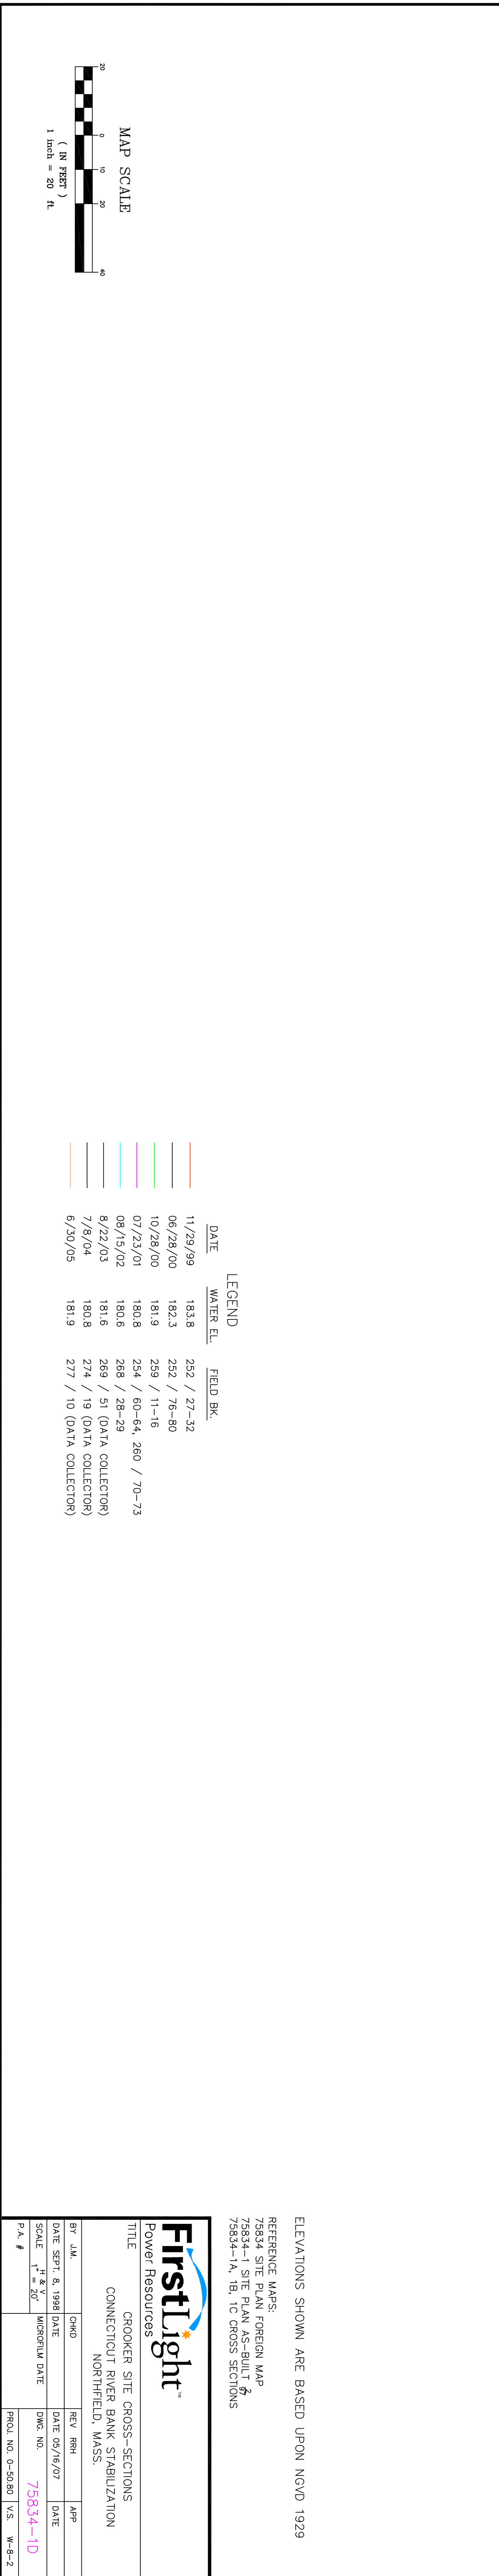
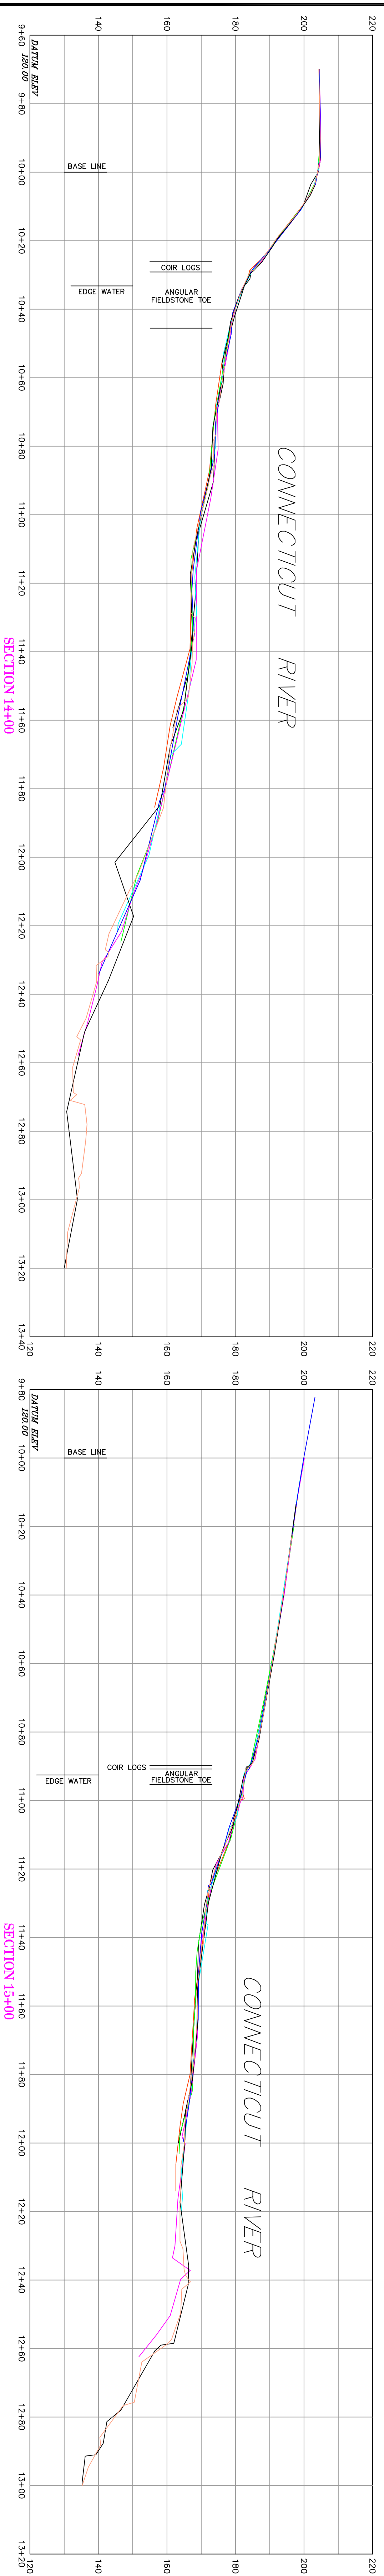


CROSS-SECTION (TYP.)  
LOOKING NORTH

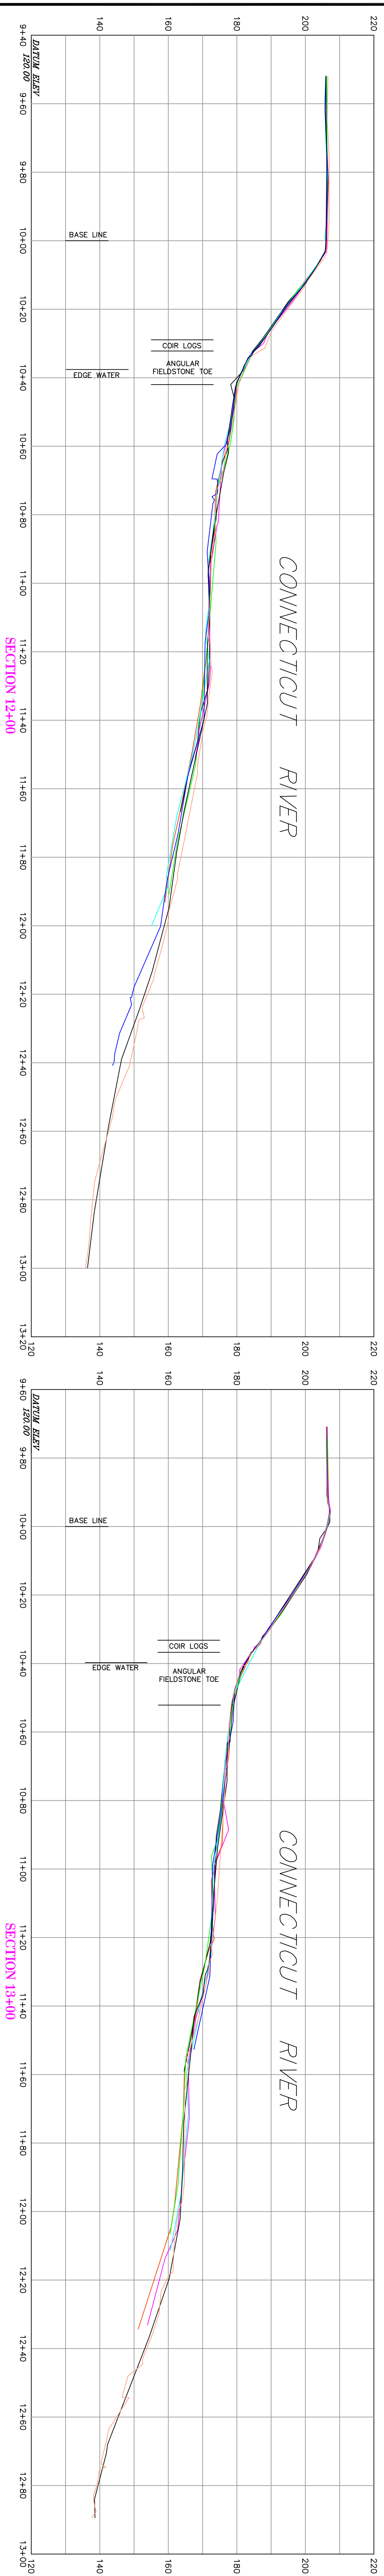

ELEVATIONS SHOWN ARE BASED UPON NGVD 1929

REFERENCE MAPS:  
75834 SITE PLAN FOREIGN MAP  
75834-1 SITE PLAN AS-BUILT  
75834-1A, 1B, 1C CROSS SECTIONS

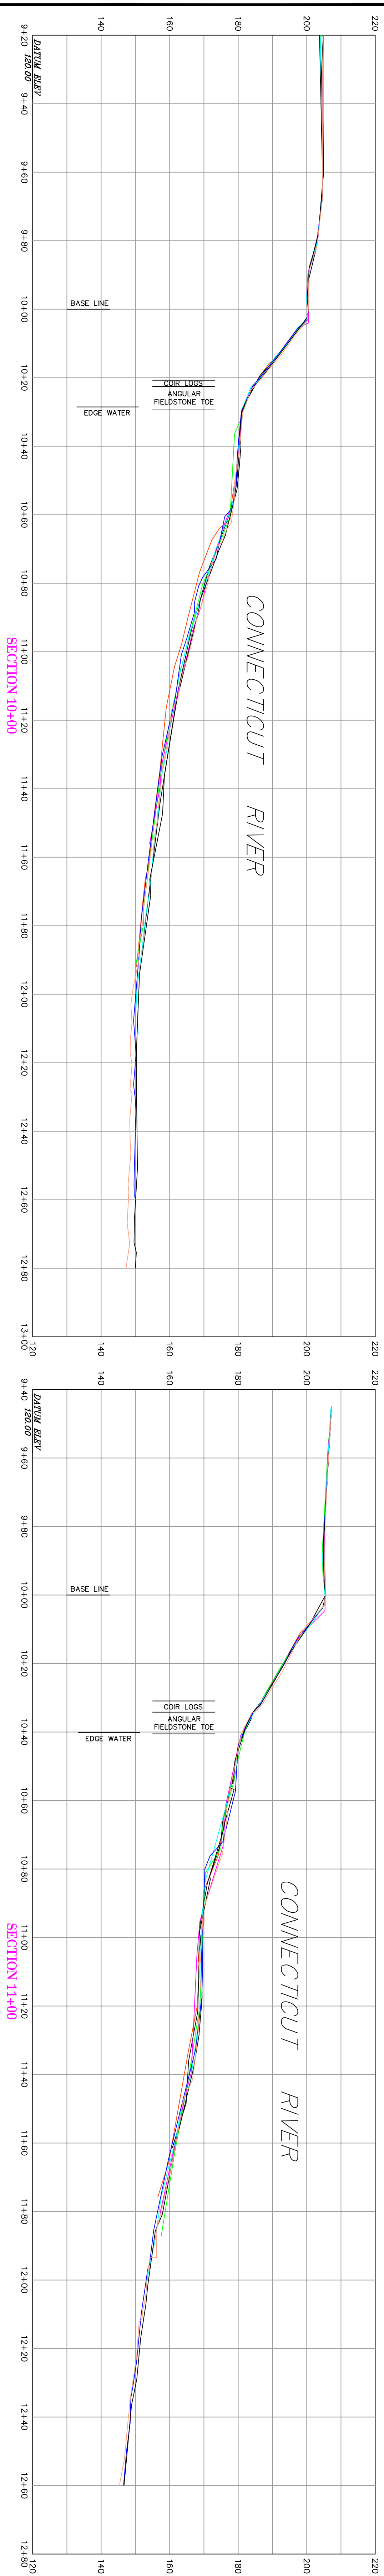

TITLE		CROOKER SITE CROSS-SECTIONS	
PROJECT		CONNECTICUT RIVER BANK STABILIZATION	
LOCATION		NORTHFIELD, MASS.	
BY: JLM	CHKD:	REV: RHR	APP:
DATE: SEPT. 8, 1998	DATE:	DATE: 05/16/07	DATE:
SCALE: 1" = 20'	INSTRUMENT DATE:	DWG. NO.:	75834-1D
P.A. #	PROJ. NO. 0-5680	V.S.:	W-8-2

LEGEND

DATE	WATER EL.	FIELD BK.
11/29/99	183.8	252 / 27-32
06/28/00	182.3	252 / 76-80
10/28/00	181.9	259 / 11-16
07/23/01	180.8	254 / 60-64, 260 / 70-73
08/15/02	180.6	268 / 28-29
8/22/03	181.6	269 / 51 (DATA COLLECTOR)
7/8/04	180.8	274 / 19 (DATA COLLECTOR)
6/30/05	181.9	277 / 10 (DATA COLLECTOR)

